## DART SERVICE INSTRUCTION

TO AMEND INSTALLATION INSTRUCTIONS D205-634 REV. E AND INSTRUCTIONS FOR CONTINUED AIRWORTHINESS ICA-D205-634 REV. 2

REF. CANADIAN STC: SH96-88 REF. FAA STC: SR00563NY REF. EASA STC: EASA.IM.R.S.01303

## **INSTRUCTIONS:**

- 1) FOR D205-634-011 SKID TUBES @ CHANGE 007 AND SUBSEQUENT AND D205-634-015 AT CHANGE 006 AND SUBSEQUENT, REVISION B OF THIS DSI **SUPERCEDES** REVISION A (DISCARD REVISION A).
- 2) MODIFY THE FOLLOWING:
  - a) REPLACE THE D2968-041 TOW RING WITH THE D3407-041 TOW RING ASSEMBLY.
  - b) REPLACE THE D2736-1 AND D2736-3 GHW LUGS WITH THE D3405-041 AND D3405-043 LUG ASSEMBLIES:
  - c) AMEND THE PARTS LIST IN SECTION 5.0 OF INSTALLATION INSTRUCTIONS D205-634 REV. E AND SECTION 32.9 OF THE INSTRUCTIONS FOR CONTINUED AIRWORTHINESS ICA-D205-634 REV. 2 AS FOLLOWS:

NOTE: ALL INSTALLATION FASTENERS FOR THE ABOVE CHANGES HAVE BEEN UPDATED SEE THE AMENDED PARTS LIST FOR DETAILS.

CANADA
DEPARTMENT OF TRANSPORT
AIRCRAFT CERTIFICATION
BRANCH
DAO # 01-O-01

APPROVED
D. SHEPHERU (DE # 02)

DATE: 08.12.03
CERT. NO.: SH96-88
ISSUE NO.: 3

12.03	APPROVED	
96-88 3	DE APPR.	-
	DATE	

В	SHT 2	AJS	08.10.06		
Α	NEWIS	SSUE	AJS	08.07.09	
REV.			BY	DATE	
DESIGN		AUS	DART AEROSPA	\CE	LTD
DRAWN AJS		AJS	HAWKESBURY, ONTARIO, CANADA		
CHECK	ED	<u> </u>	DRAWING NO.		REV. B
MFG. APPR. N/A		N/A	DSI 9417	5	SHEET 1 OF 3
APPROVED M		IW	TITLE		SCALE
DE APPR.		-#-	SKIDTUBE INSTALLATIONS		NTS
DATE 08 10 06			COPYRIGHT © 2008 BY DART AE THIS DOCUMENT IS PRIVATE AND CONFIDENTIAL AND IS SUPPLIED	ON THE EXPRE	SS CONDITION THAT IT IS

ADDED SHEET 3 MOVED P/L TO SHEET 2

ITEM	634 -011	634 -015	634 -041	634 -045	641 -011	PART NUMBER	DESCRIPTION
	Х					D205-634-011	SKIDTUBE INSTALLATION (STANDARD)
		Х				D205-634-015	SKIDTUBE INSTALLATION (MODIFIED)
	1		Х			D205-634-041	SKIDTUBE
		1		Х		D205-634-045	SKIDTUBE
	1	1			Х	D205-641-011	GROUND HANDLING KIT
					İ	1	

IS:

-				<del>                                     </del>	
40	1	1		D3407-041	TOW RING ASSEMBLY
41	1	1		D3456-1	WASHER
43	1	1		MS21043-4	NUT
44	2	2		D3417-5	WASHER
50			1	D3405-041	LUG ASSEMBLY
51	-		1	D3405-043	LUG ASSEMBLY
52			4	AN4C47A	BOLT
53			8	D2570	BUSHING
54			4	MS21043-4	NUT

## WAS:

			<u> </u>		_	<del></del>	
40	1	1	- "			D2968-041	TOW RING
41	1	1				AN970-4	WASHER
43	1	1				MS21042L4	NUT (OR MS21042-4)
			<u> </u>	ļ			
50					1	D2736-1	GHW LUG
51					1	D2736-3	GHW LUG
52					4	AN4-46A	BOLT
_ 53					8	D2570	BUSHING
54					4	MS21042L4	NUT (OR MS21042-4)
				1			

CANADA DEPARTMENT OF TRANSPORT AIRCRAFT CERTIFICATION BRANCH DAO # 01-O-01


BY: D. SHEPHERD (DE # 02)

DATE: 08.12.03 CERT. NO.: SH96-88 08.12.03 ISSUE NO.: \_


DESIGN	AJS	DART AEROSPACE LTD		
DRAWN	AJS	HAWKESBURY, ONTARIO, CANADA		
CHECKED		DRAWING NO.	REV. B	
MFG. APPR.	N/A	DSI 9417	SHEET 2 OF 3	
APPROVED	JAN.	TITLE	SCALE	
DE APPR.	#	SKIDTUBE INSTALLATIONS	NTS	
DATE 08.1	0.06	COPYRIGHT © 2008 BY DART AEROSPACE LTD  THIS DOCUMENT IS PRIVATE AND CONFIDENTIAL AND IS SUPPLIED ON THE EXPRESS CONDITION THAT IT IS NOT TO BE USED FOR ANY PURPOSE OR COPIED OR COMMUNICATED TO ANY OTHER PERSON WITHOUT WRITTEN PERMISSION FROM BART AEROSPACE LTD.		

INSTALL TOW RING ASSEMBLY AS SHOWN BELOW (REFER TO FIGURE 3, DETAIL C OF D205-634 REV. E AND FIGURE 32-3, DETAIL C OF ICA-D205-634 REV. 2). AMEND SECTION 3.1.3 OF OF D205-634 REV. E AND SECTION 32.5 OF ICA-D205-634 REV. 2 ACCORDINGLY.

IS:

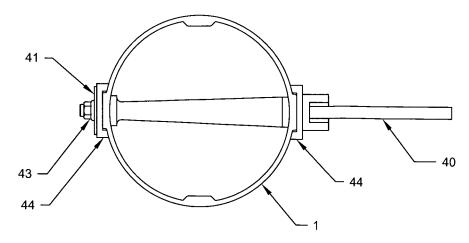

WAS:

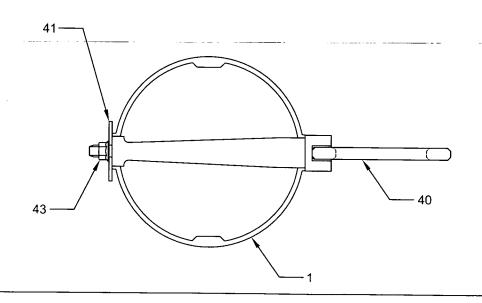

NO PICTORIAL CHANGE REQUIRED FOR GROUND HANDLING WHEEL LUG CHANGES.

CANADA
DEPARTMENT OF TRANSPORT
AIRCRAFT CERTIFICATION
BRANCH
DAO # 01-0-01

Y: D. SHEPHERIG (DE # 02)

DATE: 08.12.03
CERT. NO.: SH96-88
ISSUE NO.: 3

DESIGN AJS		DART AEROSPACE LTD			
DRAWN	AJS	HAWKESBURY, ONTARIO, CANADA			
CHECKED	lh,	DRAWING NO.	REV. B		
MFG. APPR.	N/A	DSI 9417	SHEET3 OF 3		
APPROVED	W	TITLE	SCALE		
DE APPR.	#	SKIDTUBE INSTALLATIONS	NTS		
DATE 08.1	0.06	COPYRIGHT © 2008 BY DART AEROSPACE LTD  THIS DOCUMENT IS PRIVATE AND CONFIDENTIAL AND IS SUPPLIED ON THE EXPRESS CONDITION THAT IT IS NOT TO BE USED FOR ANY PURPOSE OR COPIED OR COMMUNICATED TO ANY OTHER PERSON WITHOUT WRITTEN PERMISSION FROM DART REPOSPACE LTD.			